


▽-6.300 PLAN

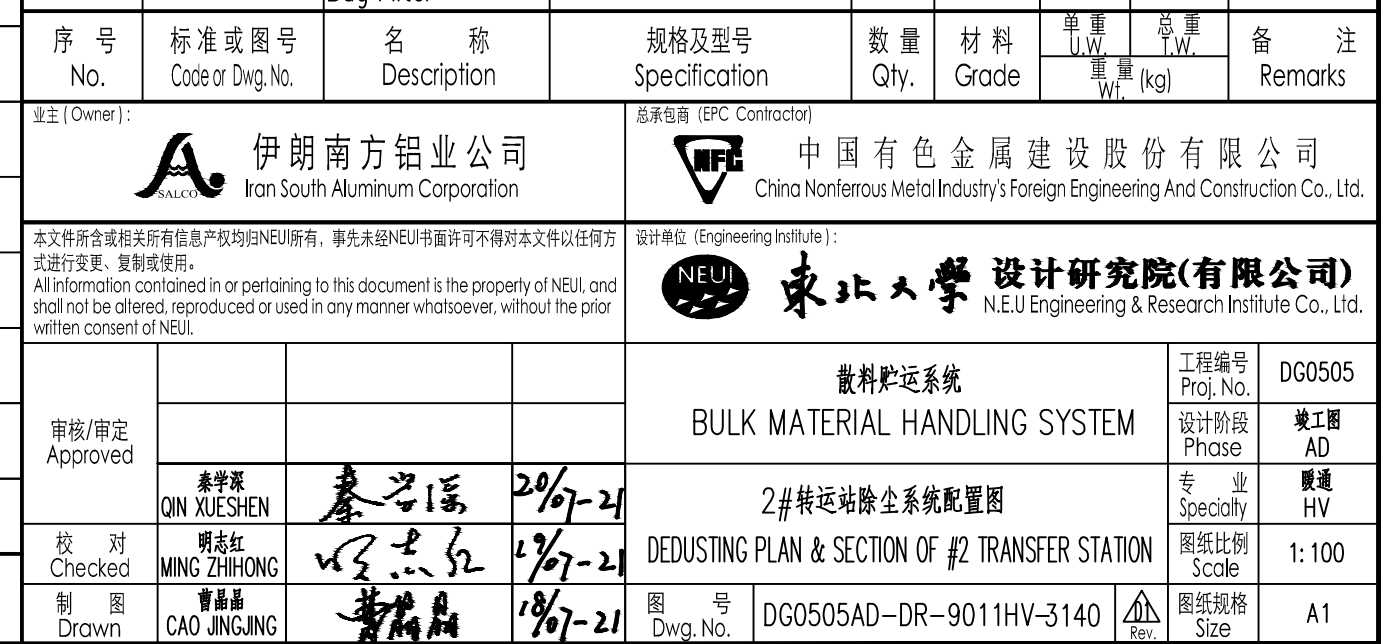

	20/07-21	AS BUILT		曹晶晶	喻志红	秦学军	
序号 Rev	日期 Date	说明 Description		制图 Drawn	校对 Checked	批准 Approved	

9011HC1034	0065640-DR-9011HC-600X	风管支架(三十槽) DUCT SUPPORT (XXXIV)	1	Q235B	17.57	17.57		
9011HC1035	0065640-DR-9011HC-600X	风管支架(三十一) DUCT SUPPORT (XXXI)	1	Q235B	8.00	8.00		
9011HC1032	0065640-DR-9011HC-600X	风管支架(三十) DUCT SUPPORT (XXX)	1	Q235B	13.09	13.09		
9011HC1050	0065640-DR-9011HC-600X	风管支架(二十九) DUCT SUPPORT (XXXIX)	1	Q235B	25.99	25.99		
9011HC1043	0065640-DR-9011HC-500	排尘罩(十四) Exhaust Hood (XIV)	H(C) 1200×800/φ480 H=600 δ=5	1	Q235B	67.26	67.26	
9011HC1042	0065640-DR-9011HC-500	排尘罩(十二) Exhaust Hood (XII)	H(C) 600×700/φ320 H=350 δ=4	1	Q235B	21.90	21.90	
9011HC1041	0065640-DR-9011HC-500	排尘罩(十三) Exhaust Hood (XIII)	H(C) 500×500/φ240 H=350 δ=4	1	Q235B	16.14	16.14	
9011HC11610		风管 Duct	450×590×4, L=1480	1	Q235B	82.2	82.2	
9011HC10339		风管 Duct	φ800×5, L=5800	1	Q235B	558.4	558.4	
9011HC10338		风管 Duct	φ800×5, L=4000	1	Q235B	109	109	
序号 No.	标准或图号 Code or Dwg. No.	名 称 Description	规格及型号 Specification	数量 Qty.	材料 Grade	单重 U.W. (kg)	总重 G.W. (kg)	备 注 Remarks